



ITM NORTH

A1

SURVEY NOTES

1. ALL LEVELS ARE RELATED TO MAIN HEAD DATUM
2. ALL DIMENSIONS ARE IN METERS UNLESS OTHERWISE STATED.
3. ANY DISCREPANCIES IN THE SURVEY SHOULD BE REPORTED TO GEODATA SURVEYING LTD IMMEDIATELY.
4. DO NOT SCALE, THIS SHALL ONLY BE PERMITTED IN DIGITAL FORM.
5. GRID IS 20m X 20m

COORDINATE SYSTEM
ITM-Irish Transverse Mercator

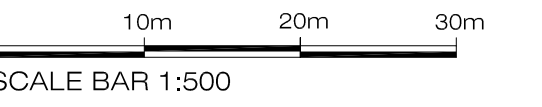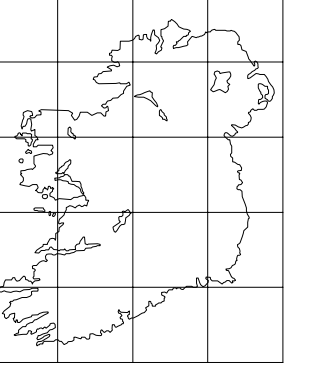

SYMBOLS

	ARMSTRONG JUNCTION		PEG REF NUMBER
	ROAD SIGN		CONTROL SURVEY STATION
	GATE		FINISH FLOOR LEVEL
	SPOT HEIGHT		RIIDGE ELEVATION
	MINI PILLAR		SOFFIT ELEVATION
	GULLY		LAMP POST
	ESB POLE		TELECOM POLE
	STRUCTURAL SLAB LEVEL		AIR VALVE
	TREE ACTUAL SPREAD		BOLLARD
	TREE TAG NUMBER		UTILITY INSPECTION CHAMBER
	WATER METER		FIRE HYDRANT
	SLUICE VALVE		INVERT LEVEL
	STOP COOK		BED LEVEL
	SPOT HEIGHT AT TOP OF WALL		SURFACE WATER LEVEL
	SPOT HEIGHT AT TOP OF TREE		HEIGHT OF WINDOW BOARD
	SPOT HEIGHT AT TOP OF HEDGE		HEAD HEIGHT OF BEAM
	SPOT HEIGHT AT TOP OF FENCE		HEAD HEIGHT OF CEILING
	BUILDING HATCH		OVERHEAD TELECOM LINE
	WALL HATCH		OVERHEAD ESB LINE
	FLAT ROOF		FILL GROUND
	MANHOLE COVER		TELE INSP CHAMBER

- EDGE OF AREA TO BE TAKEN OVER BY LOCAL COUNCIL
- AS-CONSTRUCTED SURFACE WATER
- AS-CONSTRUCTED FOUL SEWER

FOUL WATER DRAINAGE

MANHOLE NO.	COVER LEVEL	INVERT LEVEL
FWMH1	99.78	98.92
FWMH2	99.72	98.85
FWMH3	99.76	98.90
FWMH4	99.59	98.70
FWMH5	99.76	98.88
FWMH6	99.95	98.97
FWMH7	99.73	97.76
FWMH8	99.46	98.60
FWMH9	100.00	98.32
FWMH10	99.71	97.96

SURFACE WATER DRAINAGE

MANHOLE NO.	COVER LEVEL	INVERT LEVEL
SWMH1	99.64	98.44
SWMH2	99.53	98.64
SWMH3	99.50	98.08
SWMH4	99.90	98.87
SWMH5	99.70	97.94
SWMH6	99.79	98.68
SWMH7	99.64	98.51
SWMH8	99.70	97.82
SWMH9	99.58	97.08



AS BUILD SURVEY

Scale: 1:250

Buildings, Facades & Volumetric Surveys, Site Control,

GEODATA SURVEYING LTD
 MAPPING SURVEYING SETTING OUT
 Unit 2, Bandon Business Centre
 Lauragh Industrial Estate,
 Bandon, Co. Cork.

Tel: 023 8852798 Fax: 023 8852799
 email: info@geodatasurveying.ie
 Website: www.geodatasurveying.ie

Levelling, Setting out, Digital Mapping & Land Registry.

CLIENT:	SAMPLE
PROJECT:	SAMPLE
TITLE:	SAMPLE
SCALE:	1-250
DATE:	10-07-09
DWG. NO.:	09459-100